FOCAL 680
65M AHTS

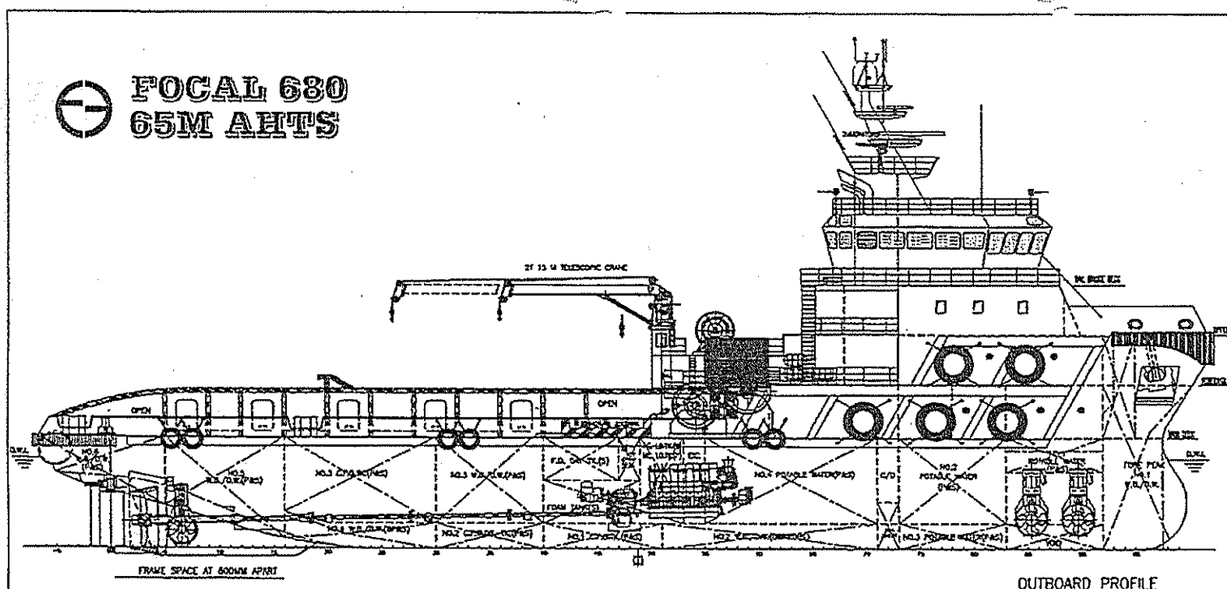

FRAME SPACE AT 600MM APART

OUTBOARD PROFILE

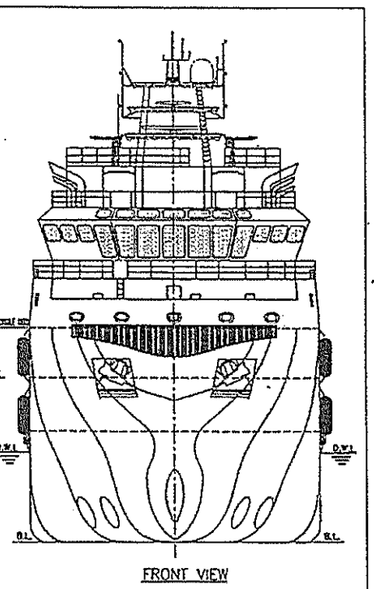

FRONT VIEW

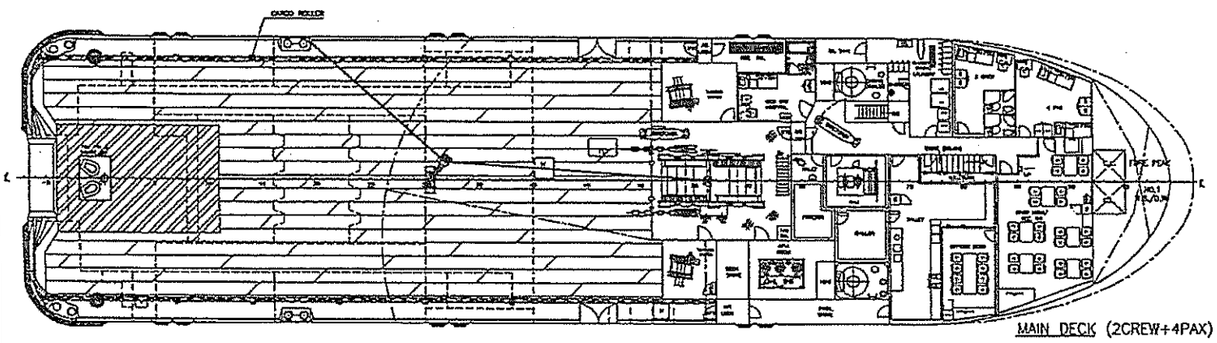

MAIN DECK (2CREW+4PAX)

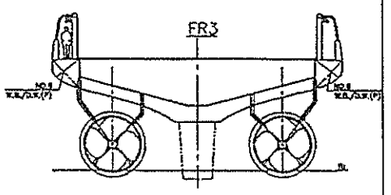

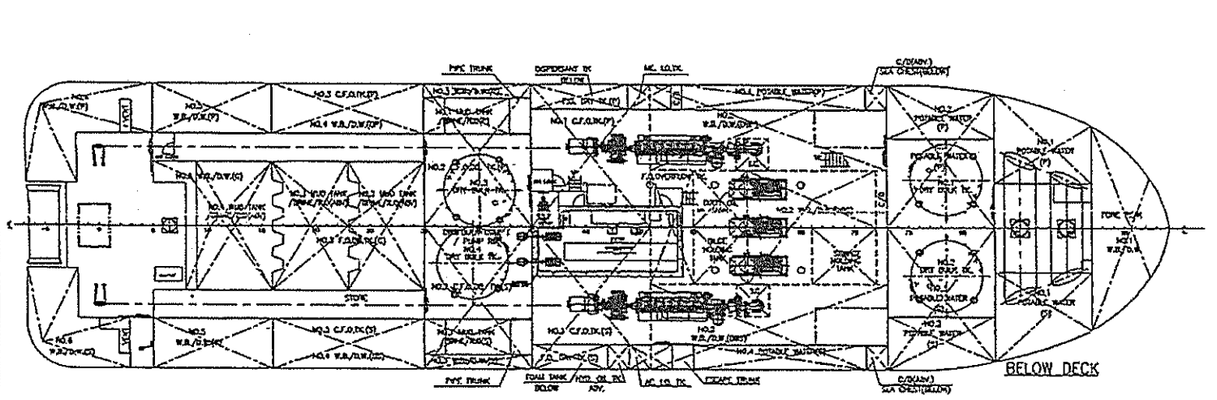

BELOW DECK

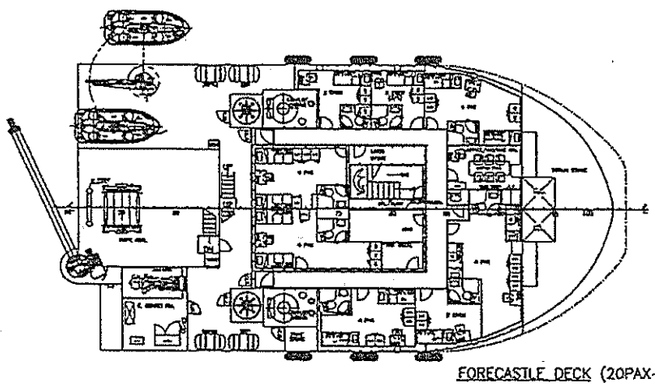

FORECASTLE DECK (20PAX+6CREW)

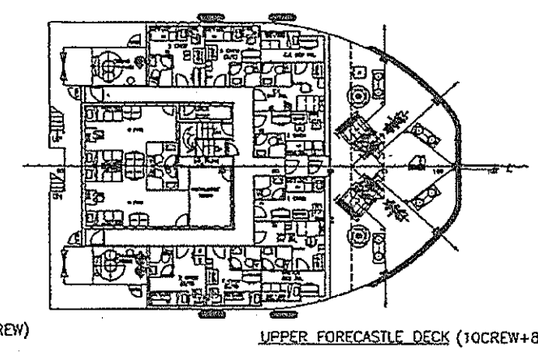

UPPER FORECASTLE DECK (10CREW+8PAX)

PRINCIPAL PARTICULARS

LENGTH OA	65.00m
LENGTH BP	58.50m
BEAM MLD.	16.00m
DEPTH MLD.	6.20m
DRAFT DESIGNED	5.00m
DRAFT SCANTLING	5.20m
COMPLEMENT	20 MEN
MAIN ENGINE	2 x 3,300 PS
TRIAL SPEED	12.5 KTS
BOLLARD PULL	80 T

APPROXIMATE CARGO CAPACITIES

DEADWEIGHT	~~1500~~ T Abt. 1800T
CARGO DECK AREA	435 M^2 @7T/M^2
DECK CARGO	600 T
FUEL OIL(INCL. C.F.O.)	580 M^3
C.F.O.	450 M^3
WB/DW	~~690~~ M^3 700
POTABLE WATER	440 M^3
MUD/BRINE/R.O.	460 M^3
CEMENT	150 M^3

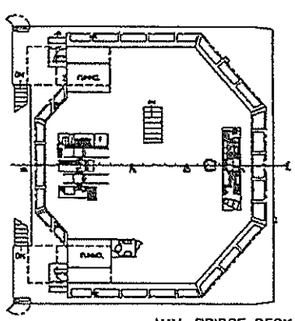

NAV. BRIDGE DECK

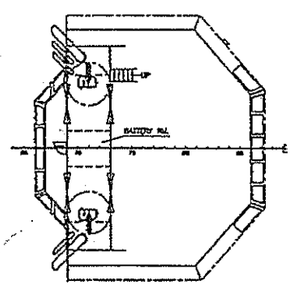

COMPASS DECK

CLASS NKS @ ⓘ OFFSHORE SUPPORT VESSEL (HOTOL, SUPPLY-HAUL, FIFI 1, ESR-01, SPS) @ AHS @ DPS-2 UWILD

THIS DOCUMENT AND THE CONTENT ARE COPYRIGHT AND REMAIN PROPERTY OF FOCAL MARINE & OFFSHORE. THEY MUST NOT BE COPIED IN WHOLE OR IN PART TO ANY THIRD PARTY FOR ANY PURPOSE WITHOUT PRIOR WRITTEN PERMISSION FROM FOCAL MARINE & OFFSHORE. THE RECEIPT OF THIS DOCUMENT IMPLIES ACCEPTANCE OF THIS CONDITION.

S11504

S11505

REV NO.	REVISION DESCRIPTION	BY	DATE
1	AMEND AS PER YARD COMMENT	ZF	JAN-13-2013

OWNER: Nam Cheong

BUILDER: FUJIAN SOUTHEAST SHIPYARD
HULL NO.: S4500/S01/S02/S03/S05/S06

PROJECT: 65M ANCHOR HANDLING TUG/OIL RECOVERY / SUPPLY VESSEL "FOCAL 680"

APPROVE		DWG TITLE: GENERAL ARRANGEMENT	JOB NO.: F-1672
VERIFIER			DWG NO.: F-1672-G01
CHECKER			SCALE: 1:150 (A1)
DRAWER	ZF		CLASS: ABS

FOCAL MARINE & OFFSHORE
EMAIL: info@focalmarine.com
SHANGHAI TEL: 86-21-58703703 FAX: 86-21-50313265
SINGAPORE TEL: 65-68481307 FAX: 65-68481291